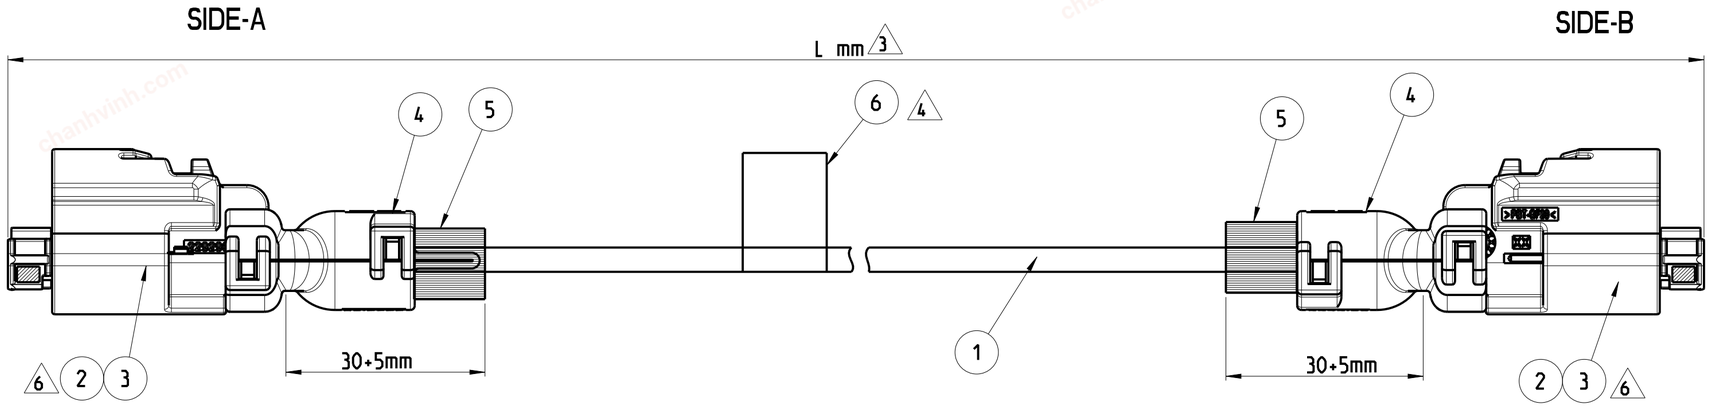
chanhvinh.com

© 2021 TE Connectivity. All Rights Reserved.

REVISIONS					
P	LTR	DESCRIPTION	DATE	DWN	APVD
	A1	PCN E-20-009212	22MAY2020	MK	GL
	A2	PCN E-20-012159	27AUG2020	MK	GL
	A3	PCN E-20-014520	13OCT2020	MK	GL
	A4	PCN E-21-002058	12FEB2021	PN	GL



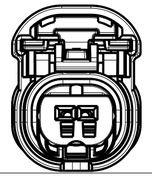
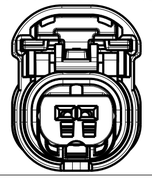
LABLE LEGEND: 4

TE CONNECTIVITY :
TE PN : SEE TABLE
REV : SEE TABLE
YYCWD

LENGTH SCHEDULE 3 7

TE PN	REV	ALIAS PART NO	LENGTH L (mm)	TOL (mm)
~~2362353-1~~	~~A~~	~~UTPB-ESFSA-ESFSA-500~~	~~500~~	~~+20~~
2362353-2	A	UTPB-ESFSA-ESFSA-100	1000	+20
2362353-3	A	UTPB-ESFSA-ESFSA-1500	1500	+30
2362353-4	A	UTPB-ESFSA-ESFSA-3000	3000	+40
2362353-5	A	UTPB-ESFSA-ESFSA-5000	5000	+40

WIRE COLOUR SCHEDULE

MCON 1.2 RECEPTACLE	CAVITY#	SIDE A	SIDE B	MCON 1.2 RECEPTACLE
	1	WHITE	WHITE	
	2	BLUE	BLUE	

NOTES :

1 PACKAGING:
ASSEMBLY IN TE STANDARD CARTON

2 ELECTRICAL TEST: 100% FOR SHORT CIRCUIT
ACC. TE SPECIFICATION 108-18857.
STANDARD TEST 3.1.1 a.b.d AND 3.1.2 d.e.m.

3 LENGTH "L" ACCORDING TABLE IS FOR STRAIGHT CABLE.

4 LABEL PRINT SEE LABEL LEGEND

5 APPLICATION SPECIFICATION FOR enetSEAL 114-151045
APPLICATION SPECIFICATION FOR MCON 1.2 mm
CONTACT SYSTEM 114-18464
INSTRUCTION SHEET FOR 1.2-mm MCON WIRE DRESS COVER 408-32185

6 RETAINER PRESENT AND CLOSED.

7 REFER LENGTH SCHEDULE.

ITEM NO.	DESCRIPTION	QTY
1	LABEL 60 X 50 MM	6
30±5mm	RNF 100 1/4 BK SP	5
2	MCON WIRE DRESS COVER, 2 POS PLUG, STRAIGHT	4
4	MCON 1.2 CB REC SRC Au	3
2	PLUG ASSEMBLY, SEALED, 2 POSITION MCON 1.2 CB	2
see table	2 POS. CABLE, 0.5 SQMM, ETHERNET, CHAMPLAIN	1

PRODUCT CHARACTERISTICS ACC. QMP EMEA_12
BESONDERE MERKMALE NACH QMP EMEA_12

TOLERANCING ISO 8015
TOLERIERUNG ISO 8015

DIESE ZEICHNUNG IST EIN KONTROLLIERTES DOKUMENT.
BEMASSUNGEN UND TOLERANZEN GEMAESS GPS (ISO STANDARDS).

THIS DRAWING IS A CONTROLLED DOCUMENT.

DWN CHANDRAKANTH 27APR2020
CHK T. BAYRAM 27APR2020
APVD G. LINDEMANN 27APR2020

DIMENSIONS: mm

TOLERANCES UNLESS OTHERWISE SPECIFIED:
0 PLC ±
1 PLC ±
2 PLC ±
3 PLC ±
4 PLC ±
ANGLES ±

MATERIAL - -
FINISH - -

PRODUCT SPEC -
APPLICATION SPEC -
WEIGHT -

CUSTOMER DRAWING

TE Connectivity

NAME ENETSEAL- FEMALE TO FEMALE CABLE ASSY
- -

SIZE	CAGE CODE	DRAWING NO	RESTRICTED TO
A2	00779	C-2362353	

SCALE 2:1 SHEET 1 OF 1 REV A4

1471-9 (3/13)